


Referenced Drawings	
Drawing Name:	Drawing No:
Drawing Name:	Drawing No:
Drawing Name:	Drawing No:

**Notes:**


This drawing is showing the refractory that was installed in order to make repairs.

Dimensions were taken in the field and may not reflect original drawings.


This drawing should not be used for fabrication or for mechanical repairs.

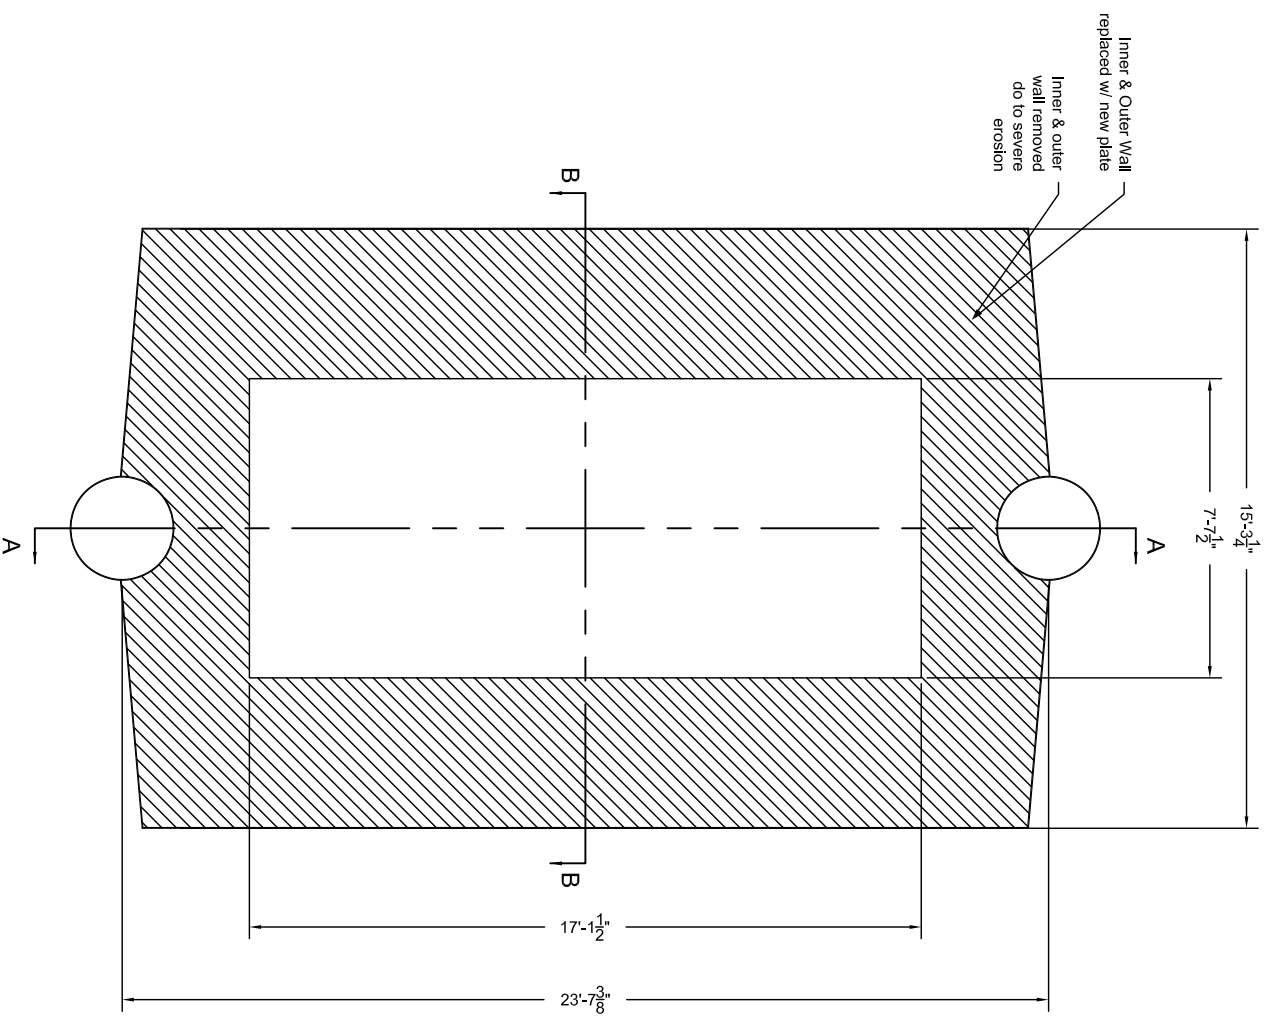

**East Elevation View**

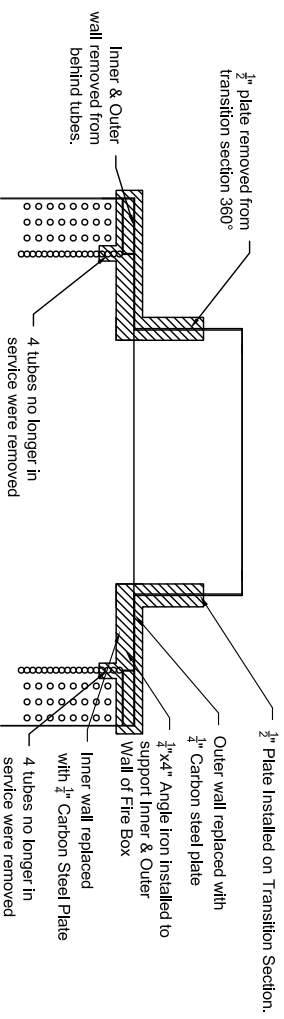

**B:B Section**

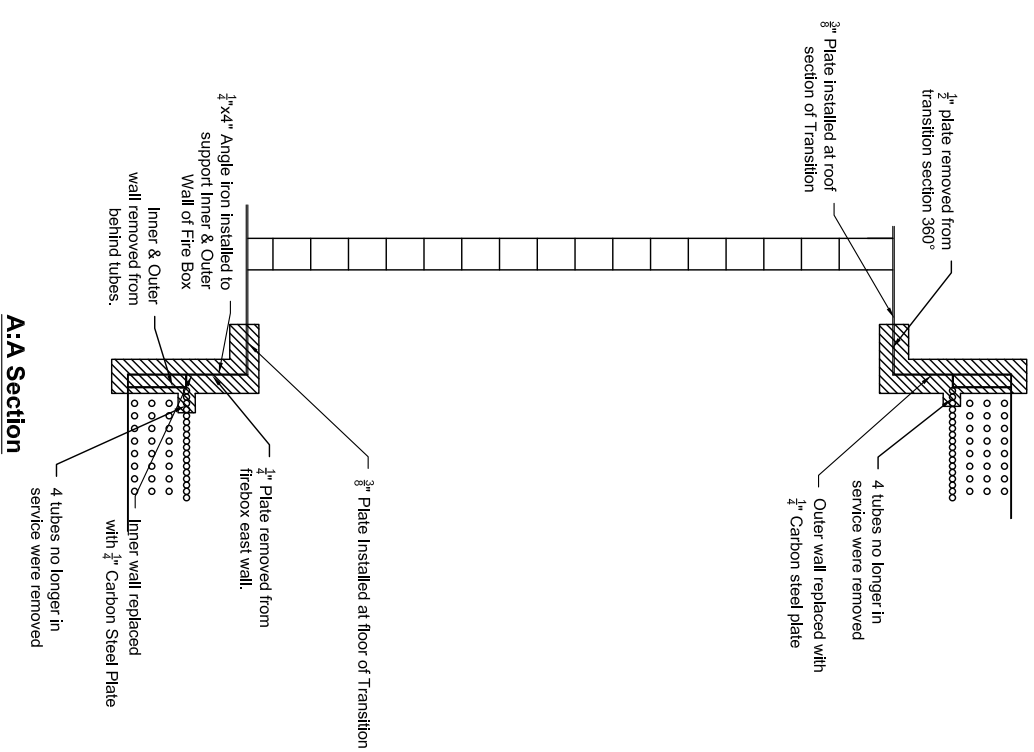

**A:A Section**

# MECHANICAL REPAIRS



Drawing Name:	Project:
<b>TRANS. TO BOILER REPAIR</b>	<b>INEOS Nitriles</b>
Drawing No:	Unit:
<b>T2B004-MECH</b>	<b>REACTOR 4</b>
Drawn By:	Date Drawn:
<b>S. Ferritta</b>	<b>12/12/2019</b>
Revised By:	Date Revised:
<b>H. Whalley</b>	<b>12/22/2019</b>
Approved By:	Date Approved:
<b>M. Whalley</b>	<b>12/22/2019</b>
Scale:	Rev:
<b>N/A</b>	<b>0</b>
Sheet:	1/6